


1

Ground Floor


1:100

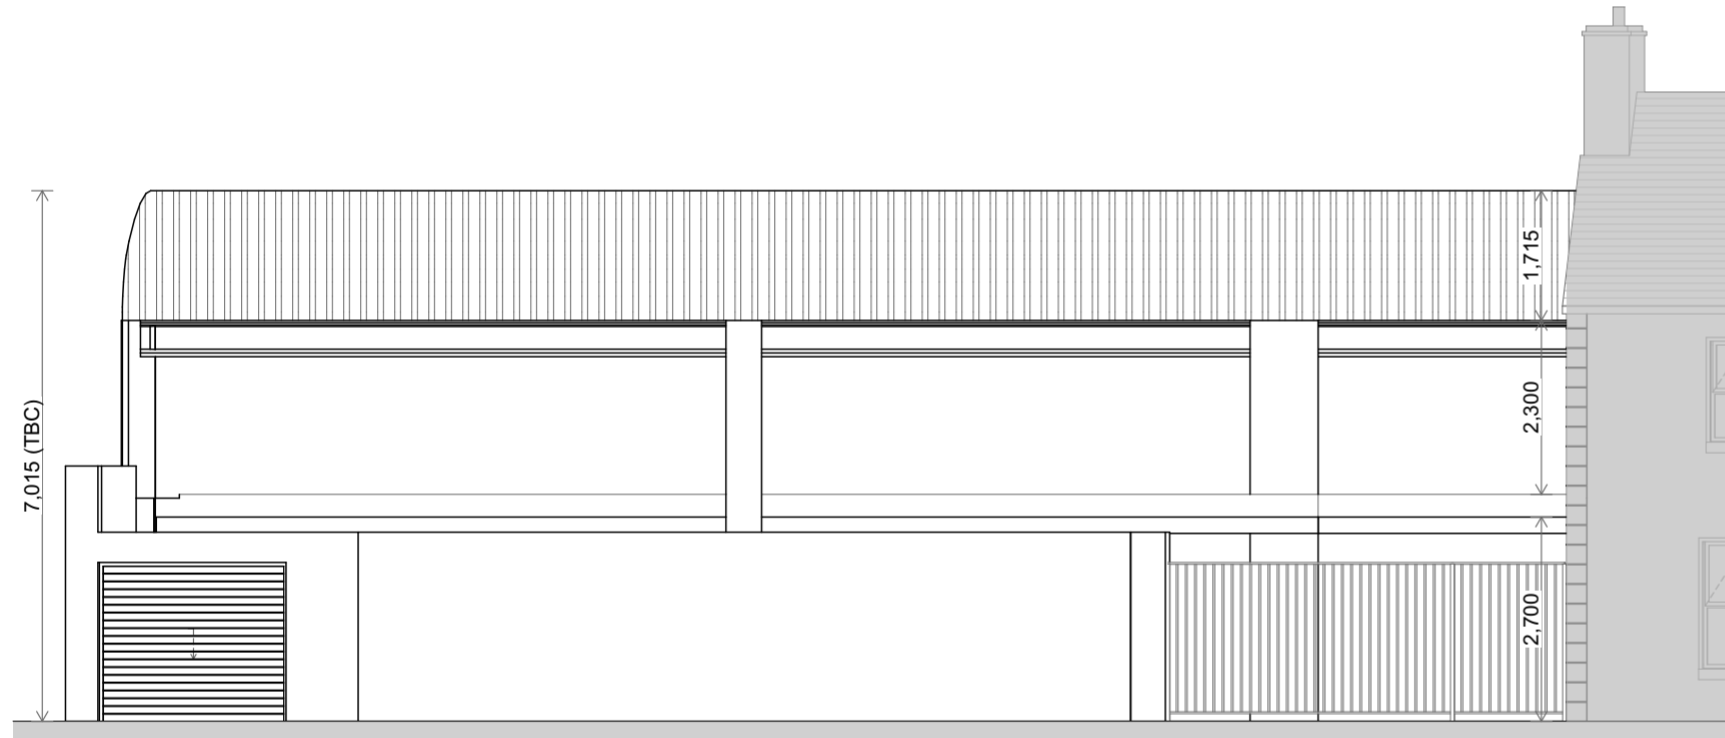

2

Front Elevation

1:100

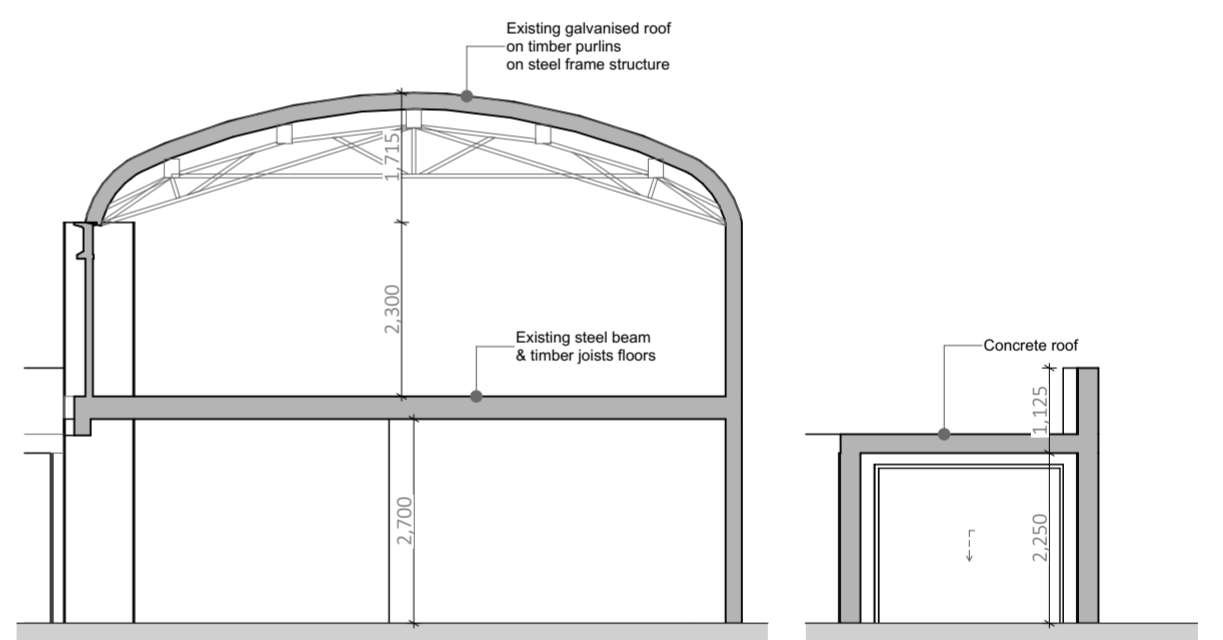

Section A-A

1:100

Section B-B 1:100



Image No.1



Image No.2



Image No.3



Image No.4



Image No.5



Image No.6



Image No.7



Image No.8



Image No.9



Image No.10



Image No.11 - First Floor



| Rev | Issue Date | Description | Approved by |
|-----|------------|-------------|-------------|
| | | | |

Purpose of Issue

'As Built' Survey

Wynne Gormley Architects & Surveyors Ltd.

© WGG ARCHITECTS & SURVEYORS LTD
COPYRIGHT RESERVED

JOB DETAILS

'As Built' survey of existing shed @ Main Street, Kinelack, Co. Cavan for Cavan County Council

Scale @ A2
As indicated

Dwg.no
PL 22-075-302

Amend.

Date
04/07/2023

Description
Existing Shed to be demolished - Floor Plans, Elevation, Section & Photos

Drawn by
J. Mrowiec

Checked by
E. Gilsenan

21, Church View, Cavan
T +353 49 43 61096
F +353 49 43 62907
E info@wggarchitects.ie
W www.wggarchitects.ie

