




1 Ground Floor - Demolition 1:50

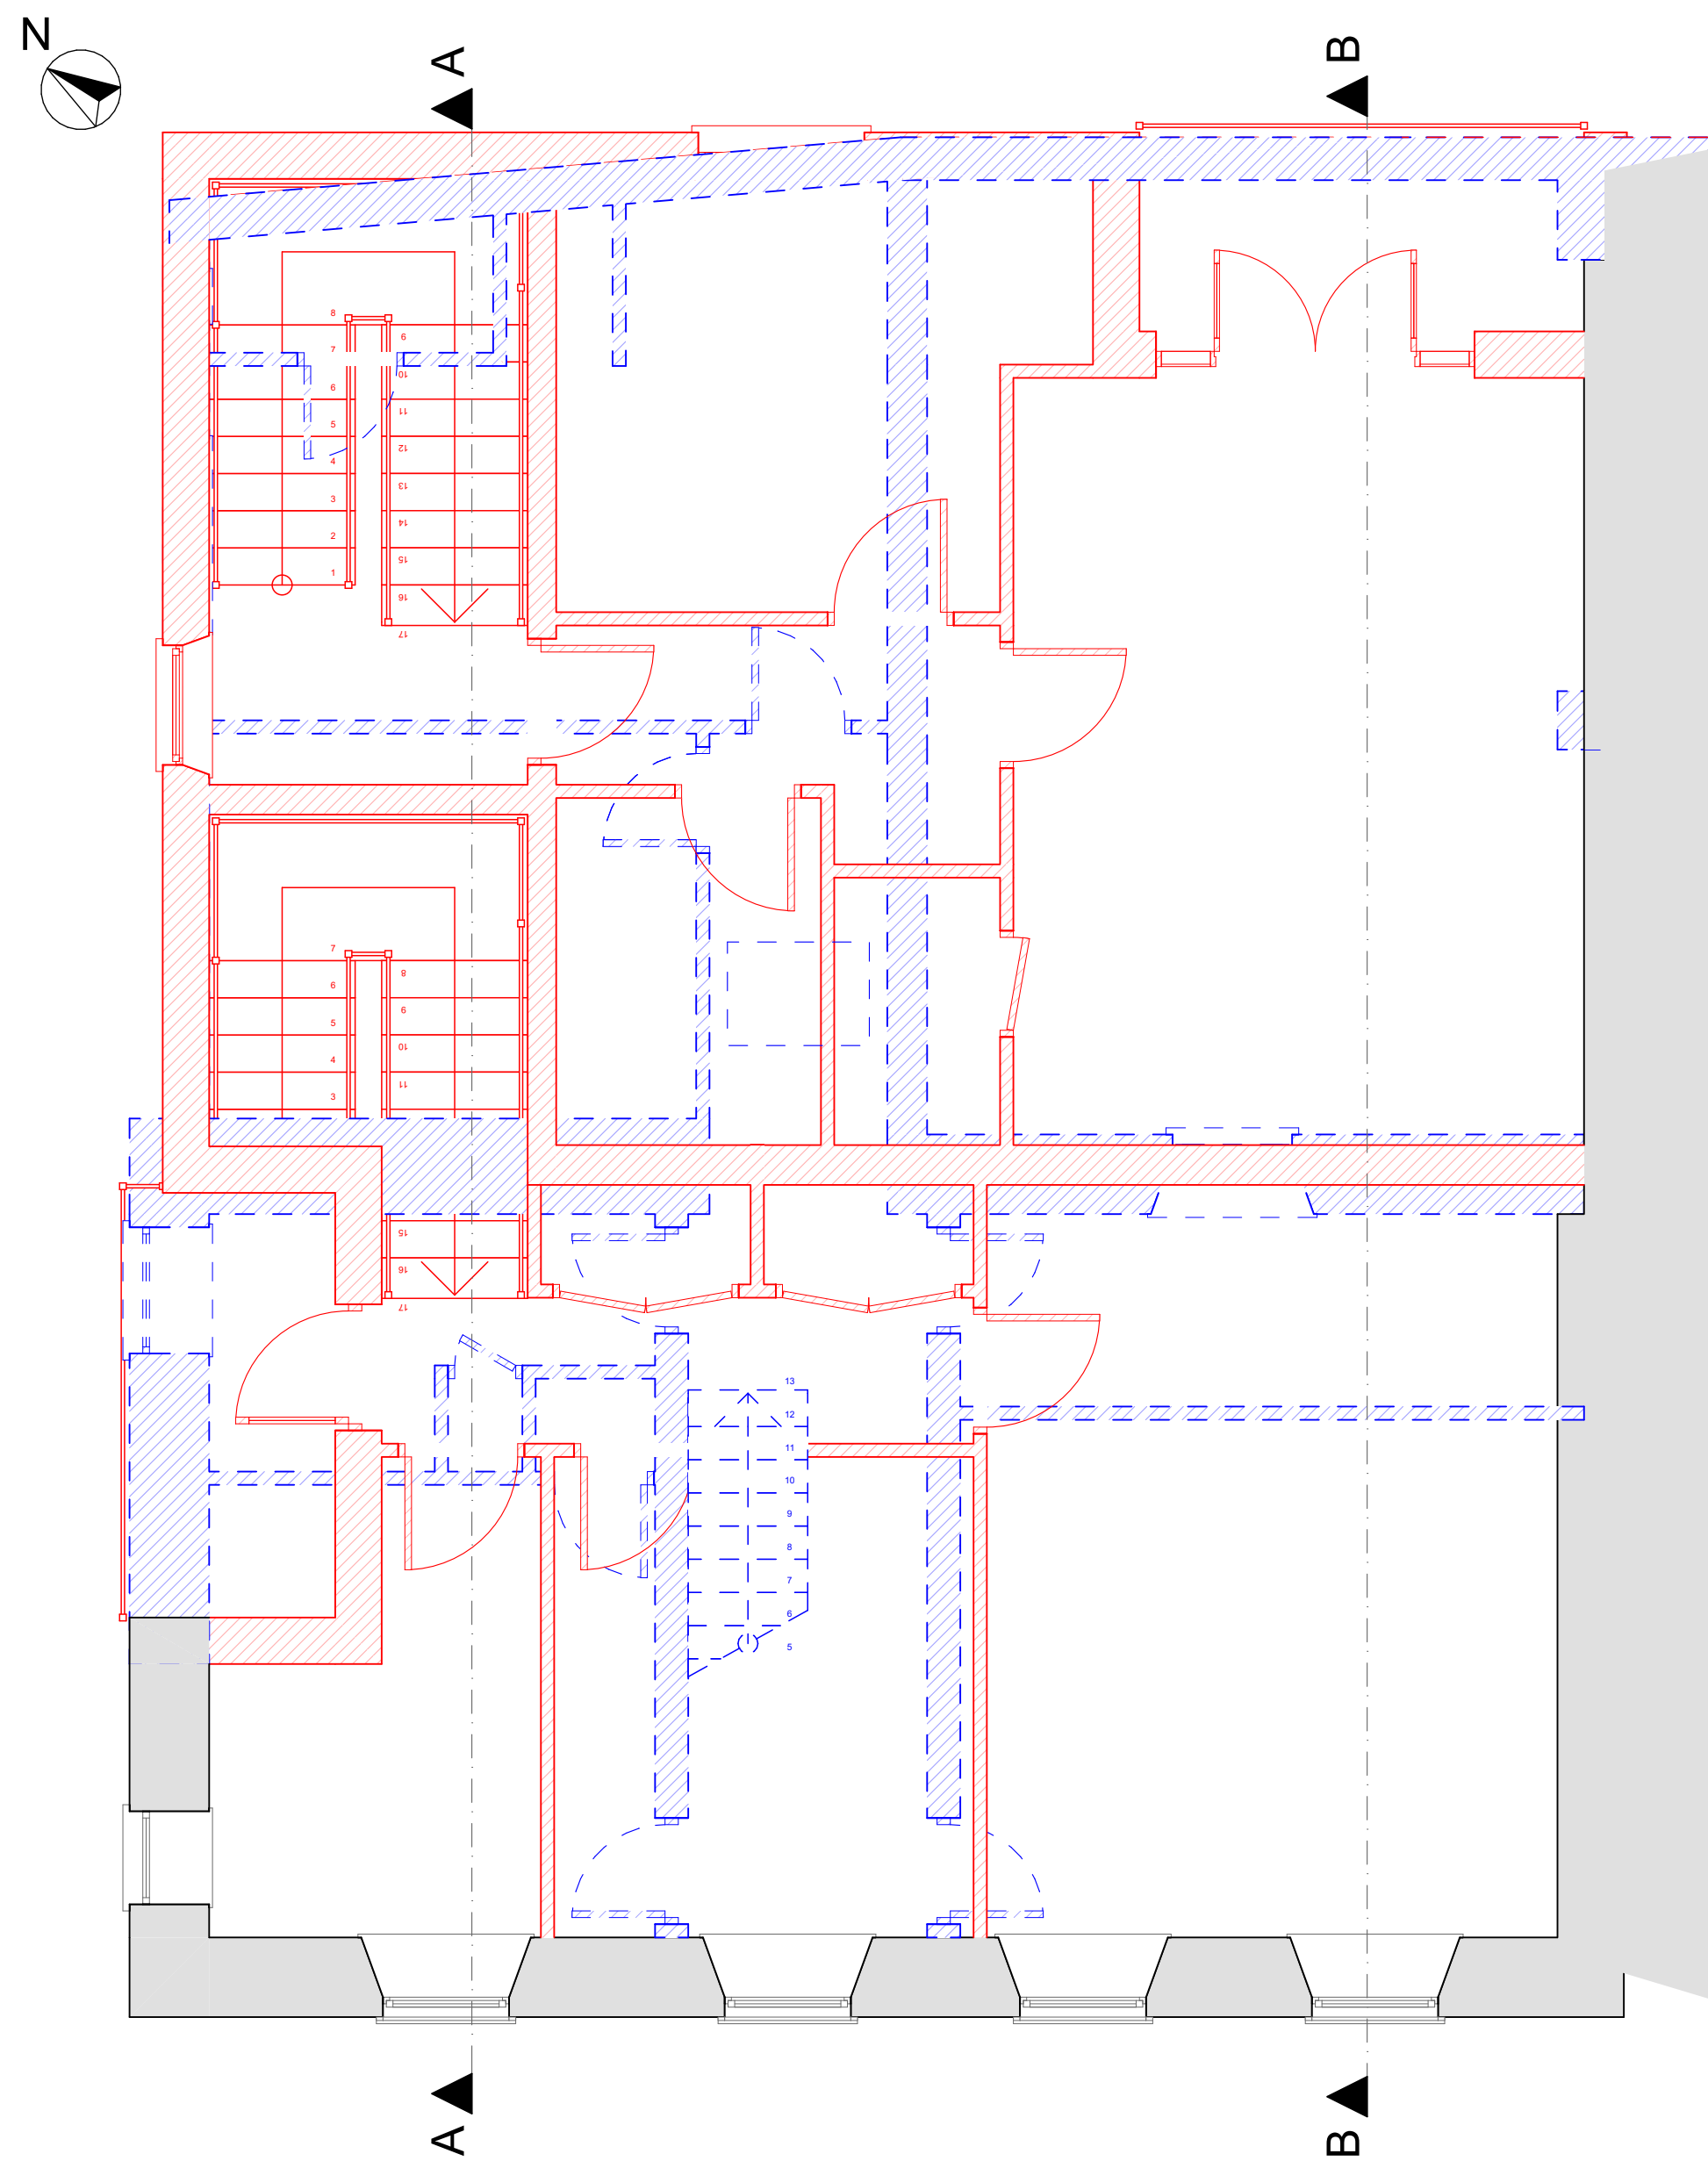


2 First Floor - Demolition 1:50

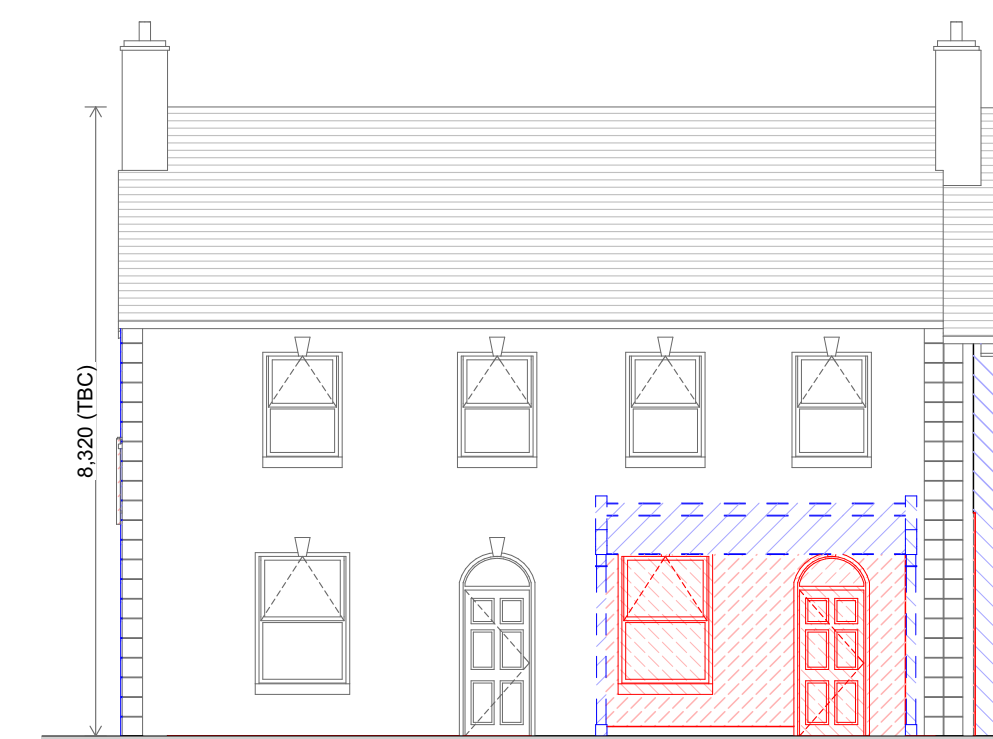

3 Front Elevation - Demolition 1:100

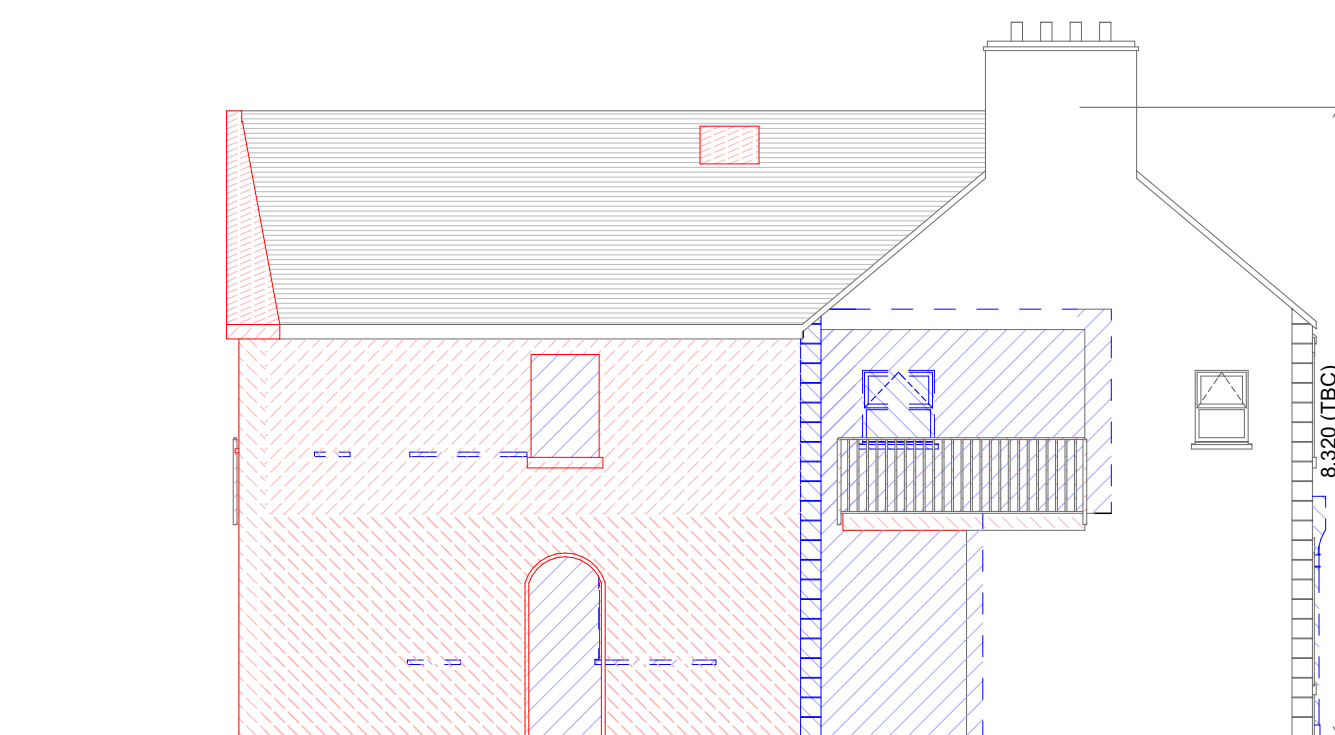

4 Side Elevation - Demolition 1:100

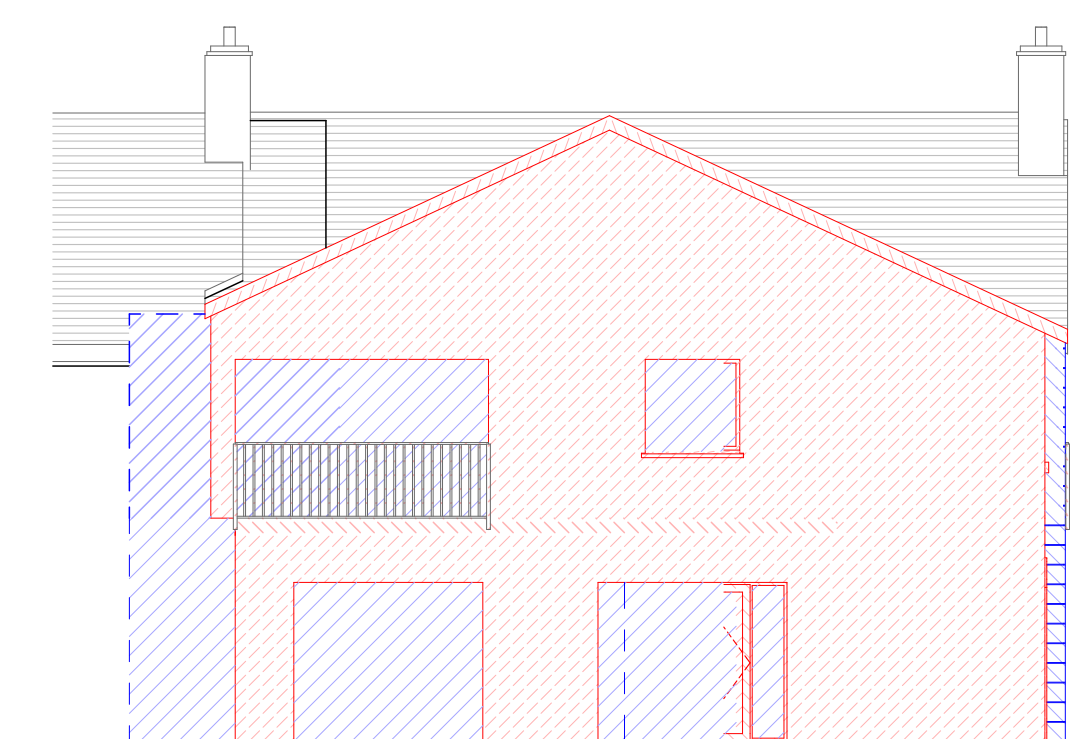

Rear Elevation - Demolition 1:100

Renovation Legend	
To Be Demolished	
Existing	
New	

Renovation Legend



Rev	Issue Date	Description	Approved by

Purpose of Issue
PLANNING DRAWING ONLY

Wynne Gormley Architects & Surveyors Ltd.
Gilsenan Surveyors Ltd.

© WGG ARCHITECTS & SURVEYORS LTD
COPYRIGHT RESERVED

JOB DETAILS
**'As Built' survey of existing dwelling @
Main Street, Kilmelack, Co. Cavan for Cavan
County Council**

Scale @ A1	Dwg no	Amend.
As indicated	PL 22-075-311	
Date	Description	
22/06/2023	Demolition - Plan Views, Elevations & Sections	
Drawn by		
J. Mrowiec		
Checked by		
E. Gilsenan		

21, Church View, Cavan
T +353 49 43 61096
F +353 49 43 62907
E info@wggarchitects.ie
W www.wggarchitects.ie

